
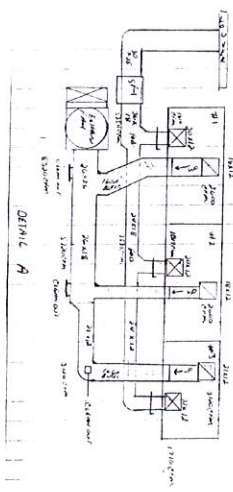


[illegible]

SECTION AT KITCHEN


SCALE 1/4" = 1'-0"

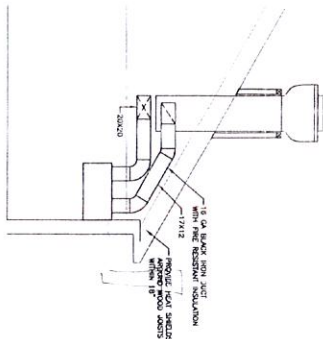


DETAIL A


FIRST FLOOR PLAN
SCALE 1/8" = 1'-0"

SCALE 1/8" = 1'-0"

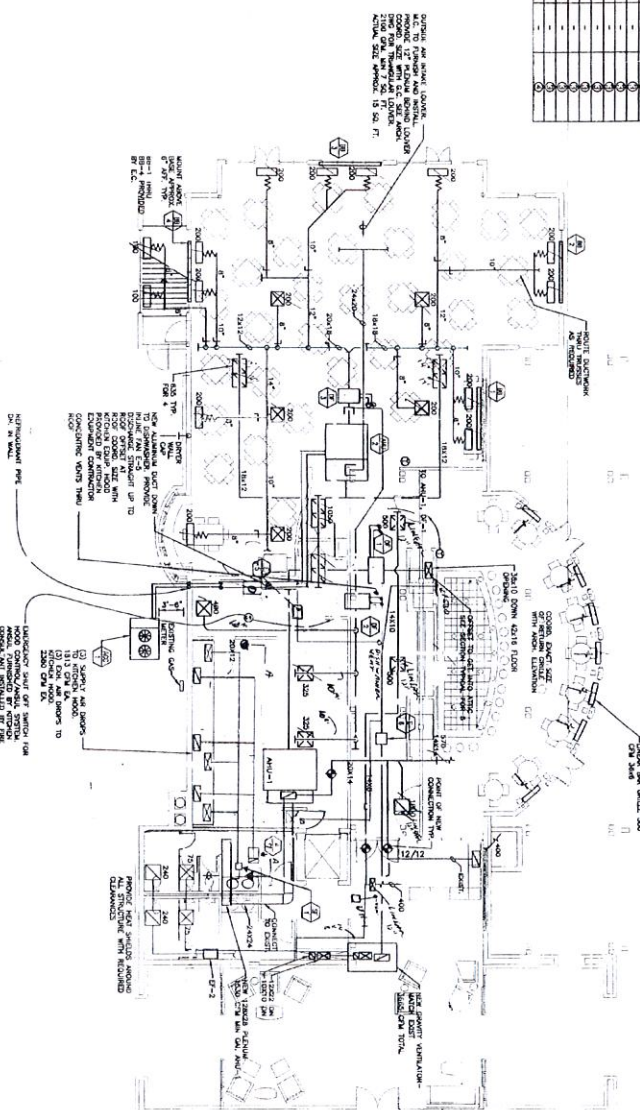


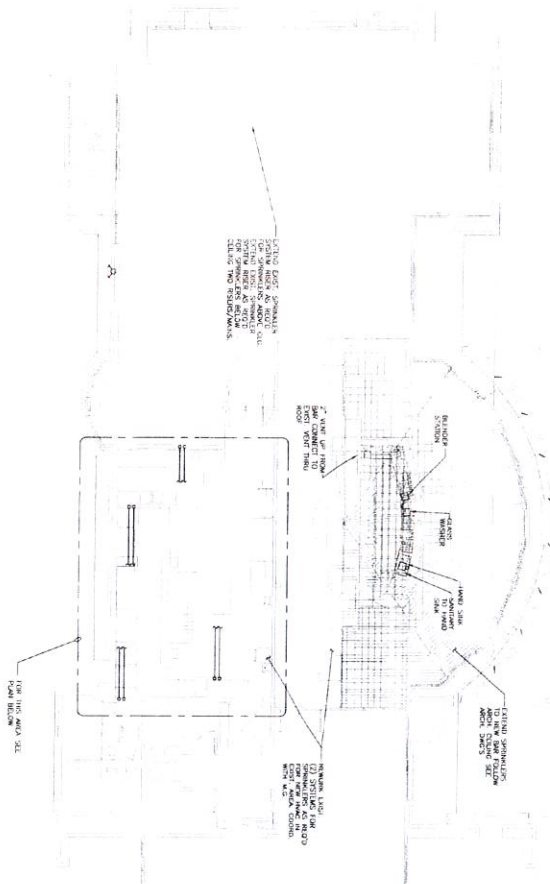


FIRST FLOOR PLAN
SCALE 1/8" = 1'-0"

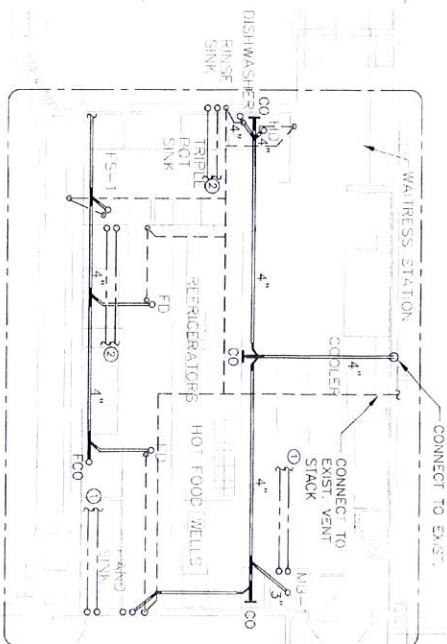

KITCHEN PLAN
SCALE 1/4" = 1'-0"

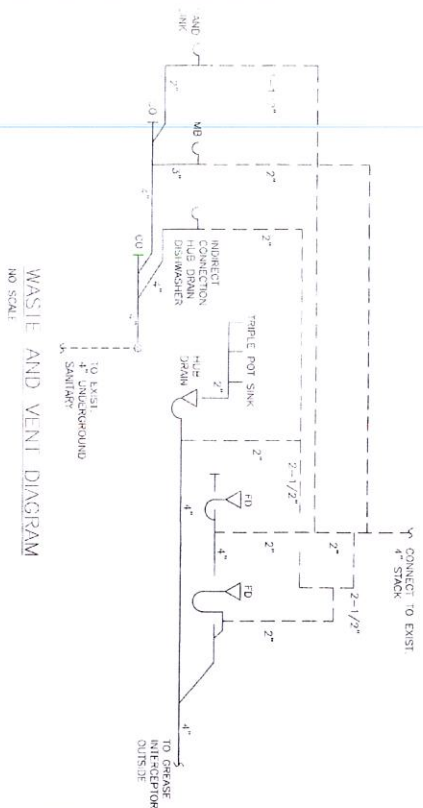

WASTE AND VENT DIAGRAM
NO SCALE

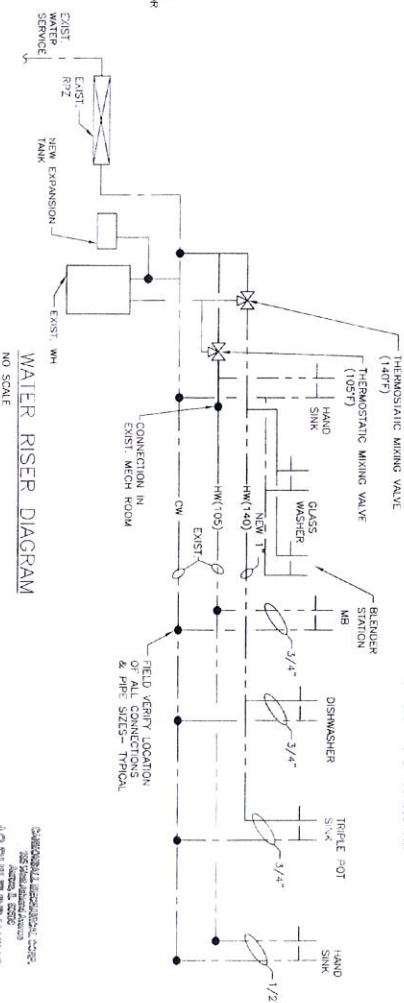

WATER RISER DIAGRAM
NO SCALE

AS BUILT DRAWING