


PLAT OF SURVEY

LOT 1 OF DOLAN-LIES SUBDIVISION, A SUBDIVISION IN SECTION 2, TOWNSHIP 38 NORTH,
RANGE 8 EAST OF THE THIRD PRINCIPAL MERIDIAN, IN KANE COUNTY, ILLINOIS, RECORDED
JULY 6, 2000 AS DOCUMENT NO. 2000K053328, KANE COUNTY, ILLINOIS.

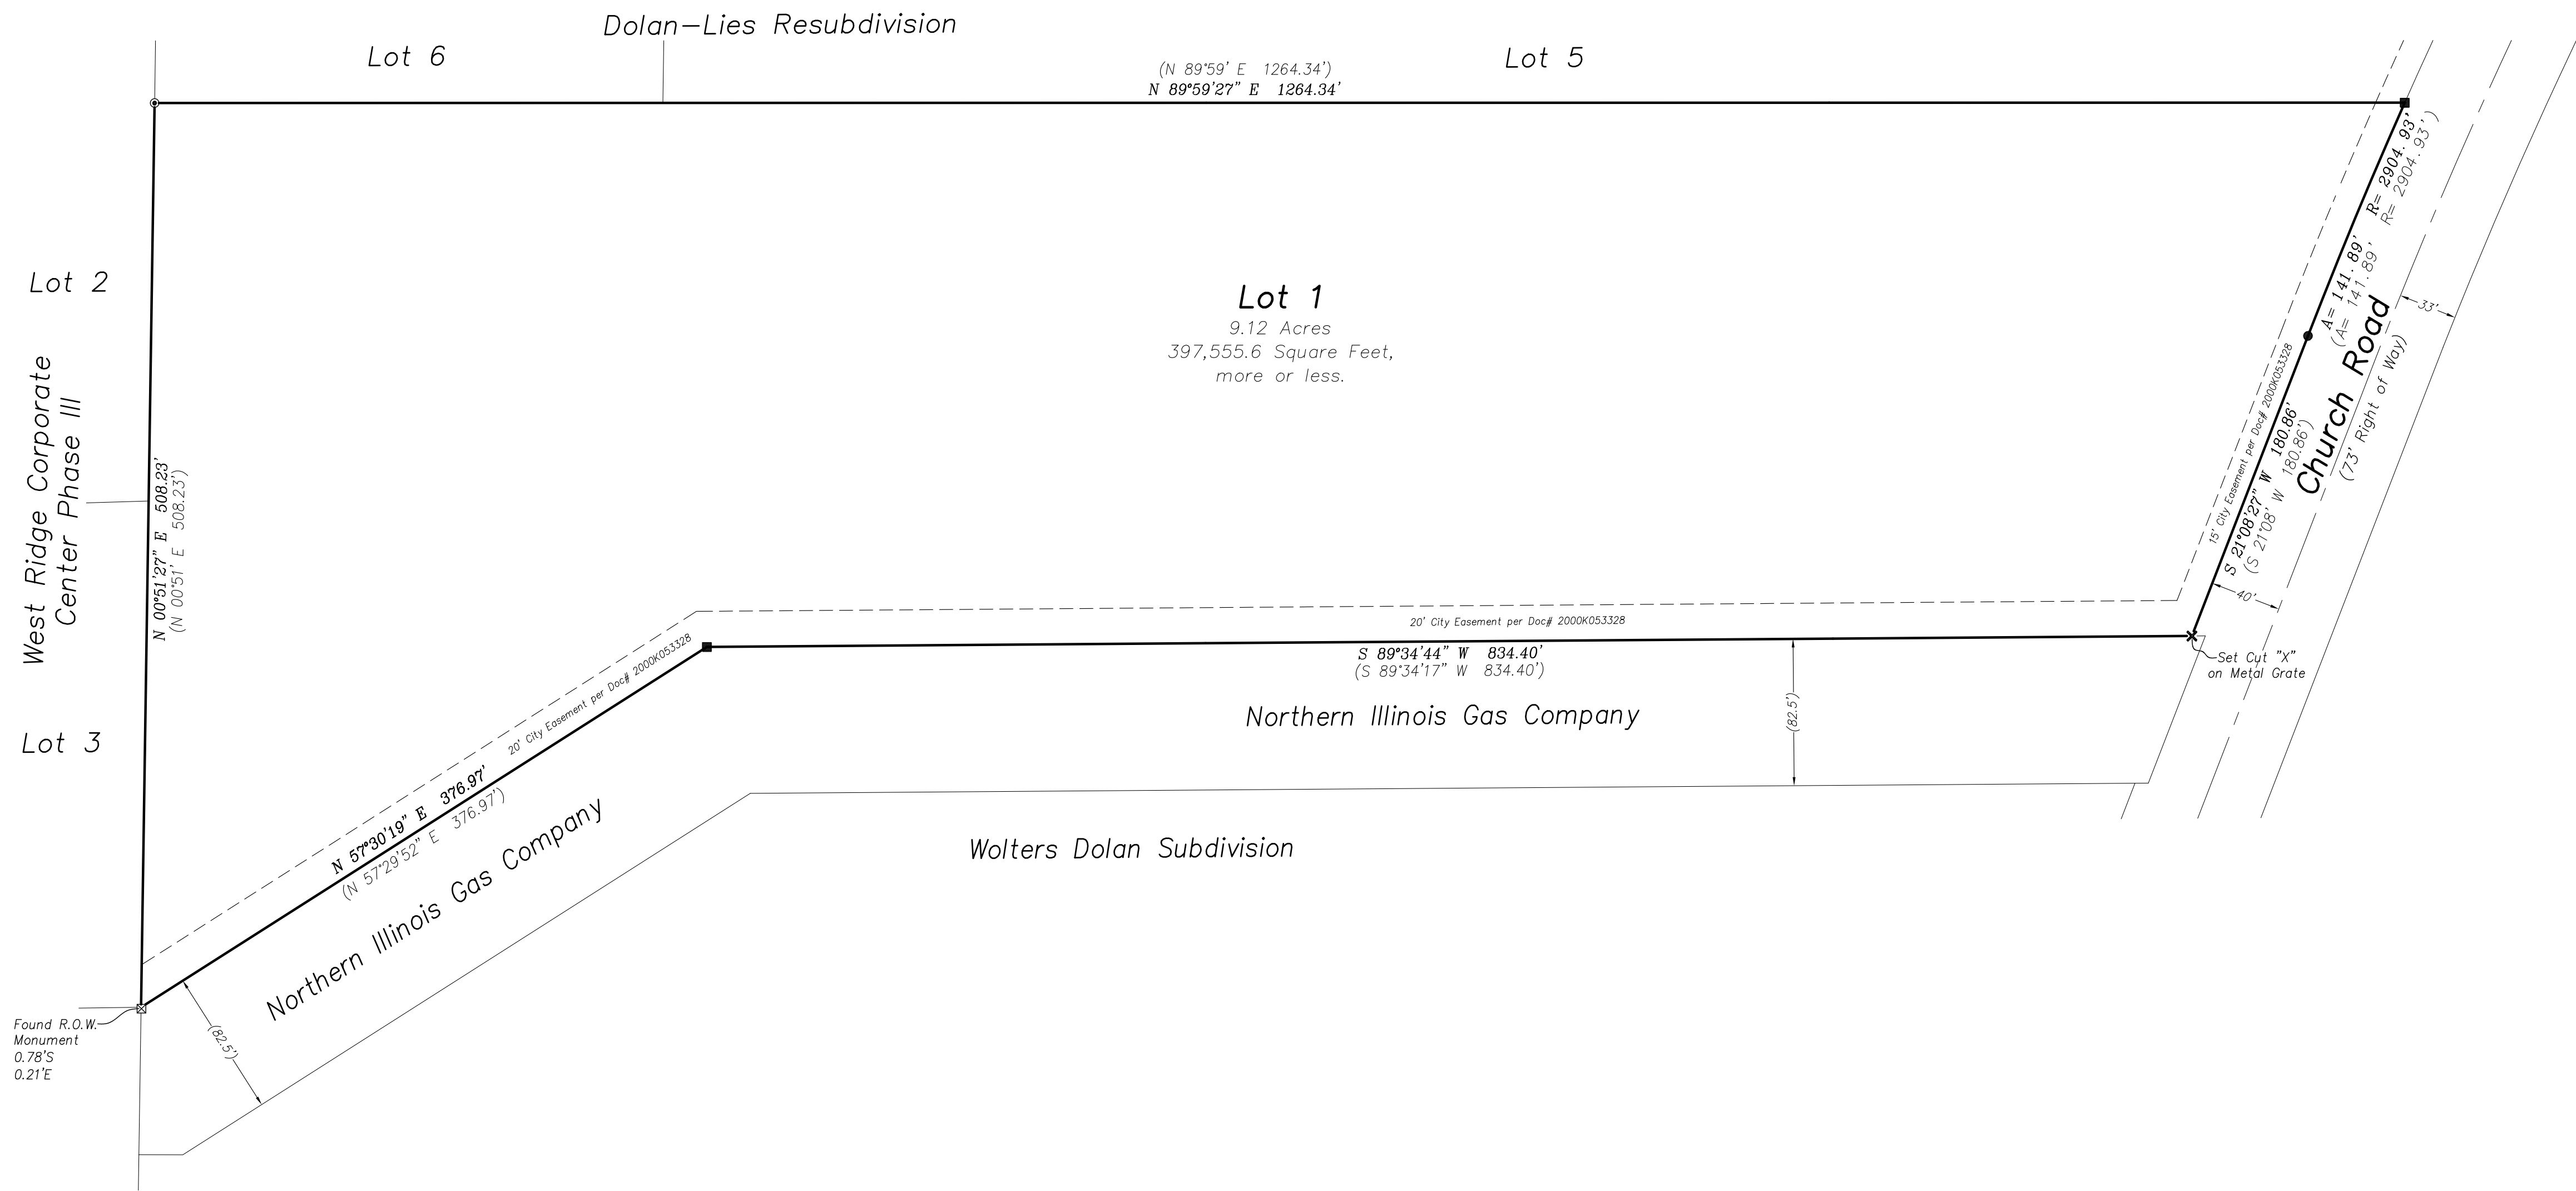

Scale: 1" = 60'

●=Found 1/2" Dia. Iron Rod
●=Set Iron Pipe 1/2" Dia. x 24"
X=Set Cut Cross
■=Set Concrete Monument

N = North E = East
S = South W = West
(XX.XX) = Record Distance
XX.XX = Measured Distance
R=Radius A=Arc Length

Michel C. Ensalaco, P.L.S. 2768, Exp. 11/30/2016
Eric C. Pokorny, P.L.S. 3818, Exp. 11/30/2016

TODD SURVEYING
Professional Land Surveying Services
"Cornerstone Surveying PC"

759 John Street, Suite D
Yorkville, IL 60560
Phone: 630-892-1309 Fax: 630-892-5544

Survey is only valid if original seal is shown in red.

Client: Tebrugge Engineering		
Book #	N/A	Drawn By: [] Plat #
Reference:		
Field Work Completed:		
Rev.	Date	Rev. Description
10/26/16		Easement revisions & additions
Project Number:		
2016-1327 SURVEY		