


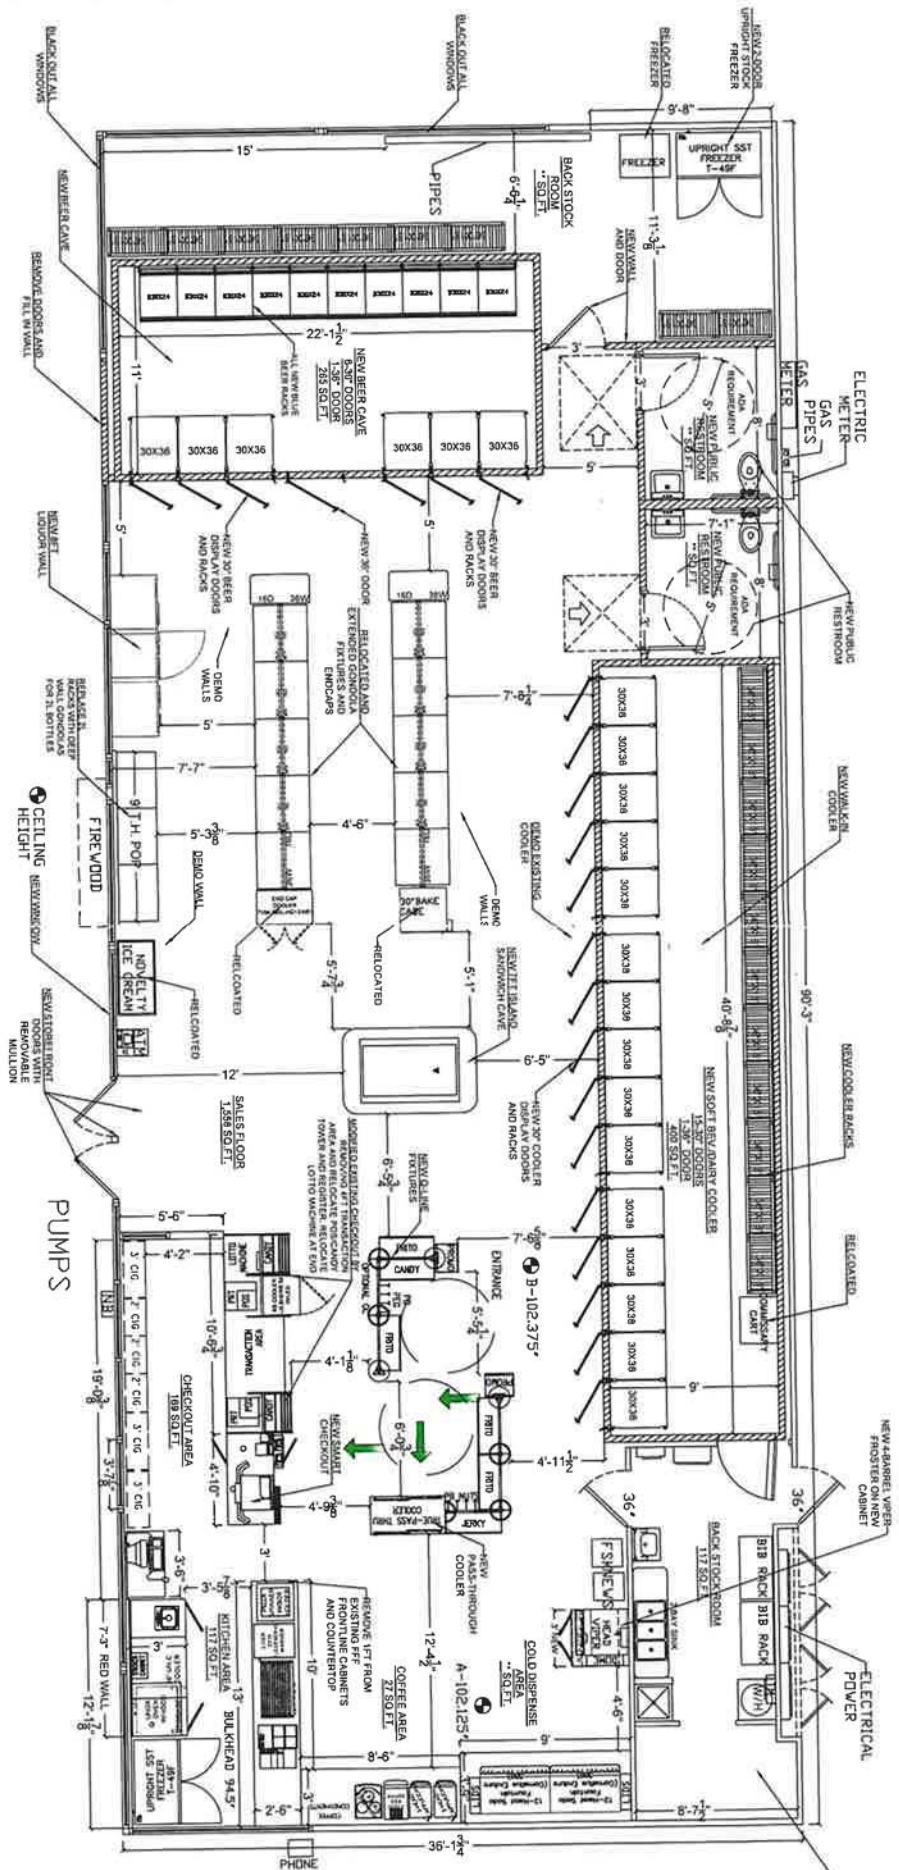

CIRCLE K

TITLE

STORE#:

KEY #:

LAST AS-BUILT BY: TZVETA RADEVA	DATE: 8/10/2023
REVISED BY: Tzvetia Radeva	DATE: 12/8/2022
DESCRIPTION: IMPACT FY25	SCALE: N.T.S.